

ILLEGIB

Approved For Release 2000/08/23 : CIA-RDP78T05439A000300280002-0

Approved For Release 2000/08/23 : CIA-RDP78T05439A000300280002-0

~~TOP SECRET CGRESS~~

DECLASSIFICATION REVIEW by NIMA/DOD 3/17/00

TCS No. 1486/64
IB No. 115/64
10 March 1964
Copy

25X1A

MEMORANDUM FOR: [REDACTED] Chief, Collection Guidance Staff

ATTENTION : [REDACTED] OBI

THROUGH : Chief, Requirements Branch, Reconnaissance Group, CGS

FROM : Chief, CIA/PID (RFIC).

SUBJECT : Highway Study, Route 9, Laos - South Vietnam

REFERENCES : (1) Requirement No. C-D14-81,092
(2) CIA/PID Project No. C 392/64

1. This memorandum is in response to the referenced requirement requesting an analysis and graphics of:

a. Trafficability of Route 9 and any newly constructed unnumbered routes.

b. Information as to width, surface, landslide areas, bottlenecks, newly construction bridges, road construction (alignment and widening) and staging areas.

c. Information on any pertinent changes upon receipt of new coverage, for the duration of the South Vietnam Task Force Study.

2. Route 9, which connects the Laoian City of Savannakhet (10 32N - 104 44E) with the Scut Vietnamese city of Dong Ha (10 49N - 107 07E), is approximately 330 km long. This road, which was a major logistical supply route between southern Laos and the northern area of South Vietnam, forms junctions with Route 13 at Seno Junction (10 40N - 104 50E) with Route 12B at 10 34N - 105 55E and with Route 23 at Muong Phine (10 32N - 106 01E). Enclosed annotated photo CIA/PID/IE-P-432/64 shows Seno Junction. The major portion of this route appear to be heavily travelled, as revealed by photography taken between

25X1D [REDACTED]. However, that portion of the road at the Laos/South Vietnam Border, which has been abandoned, does not show any signs of use during that time. Route 9A and 9B provide alternate roads for short sections of Route 9. The same general conditions prevail on Route 9A and 9B as are present on Route 9.

3. The surface of Route 9 varies from a smooth bituminous treated section in the vicinity of Tchepone (10 41N - 106 14E) and again between Seno Junction and Savannakhet, to a rough almost impossible section near the Laos/South Vietnam Border. Most of the road, however, appears to have an earth surface, which is

S-12246

~~TOP SECRET CGRESS~~

SUBJECT: Highway Study, Route 9

25X1D reinforced with gravel or broken stone. The enclosed annotated maps (CIA/PID/IE-P-429/64, P-437/64 and P-441/64) show the location of the various surface conditions over its entire route, as well as other pertinent data which were requested. The enclosed annotated photos CIA/PID/IE-P-430/64 through P-433/64 show various conditions as found on Route 9. The road is two-lane throughout with roadway widths varying from [REDACTED]. The bituminous treated sections of the road had relatively wide shoulders. The remainder of the road was graded, leaving relatively narrow shoulders throughout.

4. Route 9 traverses relatively level terrain except in the general vicinity of Muong Phine and again between the Laos/South Vietnam border and Cam Lo, South Vietnam (16°48'N - 107°00'E), where the Chaine Annamitique Mountains are encountered. Traffic speeds should not be unduly restricted by grades or curves except in the aforementioned mountains. No likely landslide areas were noted along the roadway in the mountainous areas.

5. Only one possible maintenance facility, located at Muong Phine, was observed. No fuel supplies could be identified.

6. All bridges on Route 9 were single-lane; therefore they must be considered as bottlenecks. Enclosure CIA/PID/IE-P-431/64 is a photo of a typical bridge on this route. All streams were bridged and all bridges were in, except the one located on the abandoned section of the road near the border. Enclosure CIA/PID/IE-P-433/64 is a photo of this bridge and its environs.

25X1D [REDACTED]

25X1D [REDACTED] Maps used were printed by the Army Map Service, Corps of Engineers, Series L50, maps NE 48-14 thru NE 48-16.

25X1A [REDACTED] 8. The photo analysts on this project were Messrs. [REDACTED] who may be contacted on extension 2540, should any questions arise concerning this memorandum. This is a partial answer to the referenced requirements.

25X1A

25X1A [REDACTED]


ENCLOSURES:

- 3 Annotated Maps
(CIA/PID/IE-P-429, P-437 and P-441/64)
- 4 Annotated Photos
(CIA/PID/IE-P-430/64 through P-433/64)

INDOCHINA AND THAILAND 1:250,000

ROI ET

TOP SECRET-CHESS

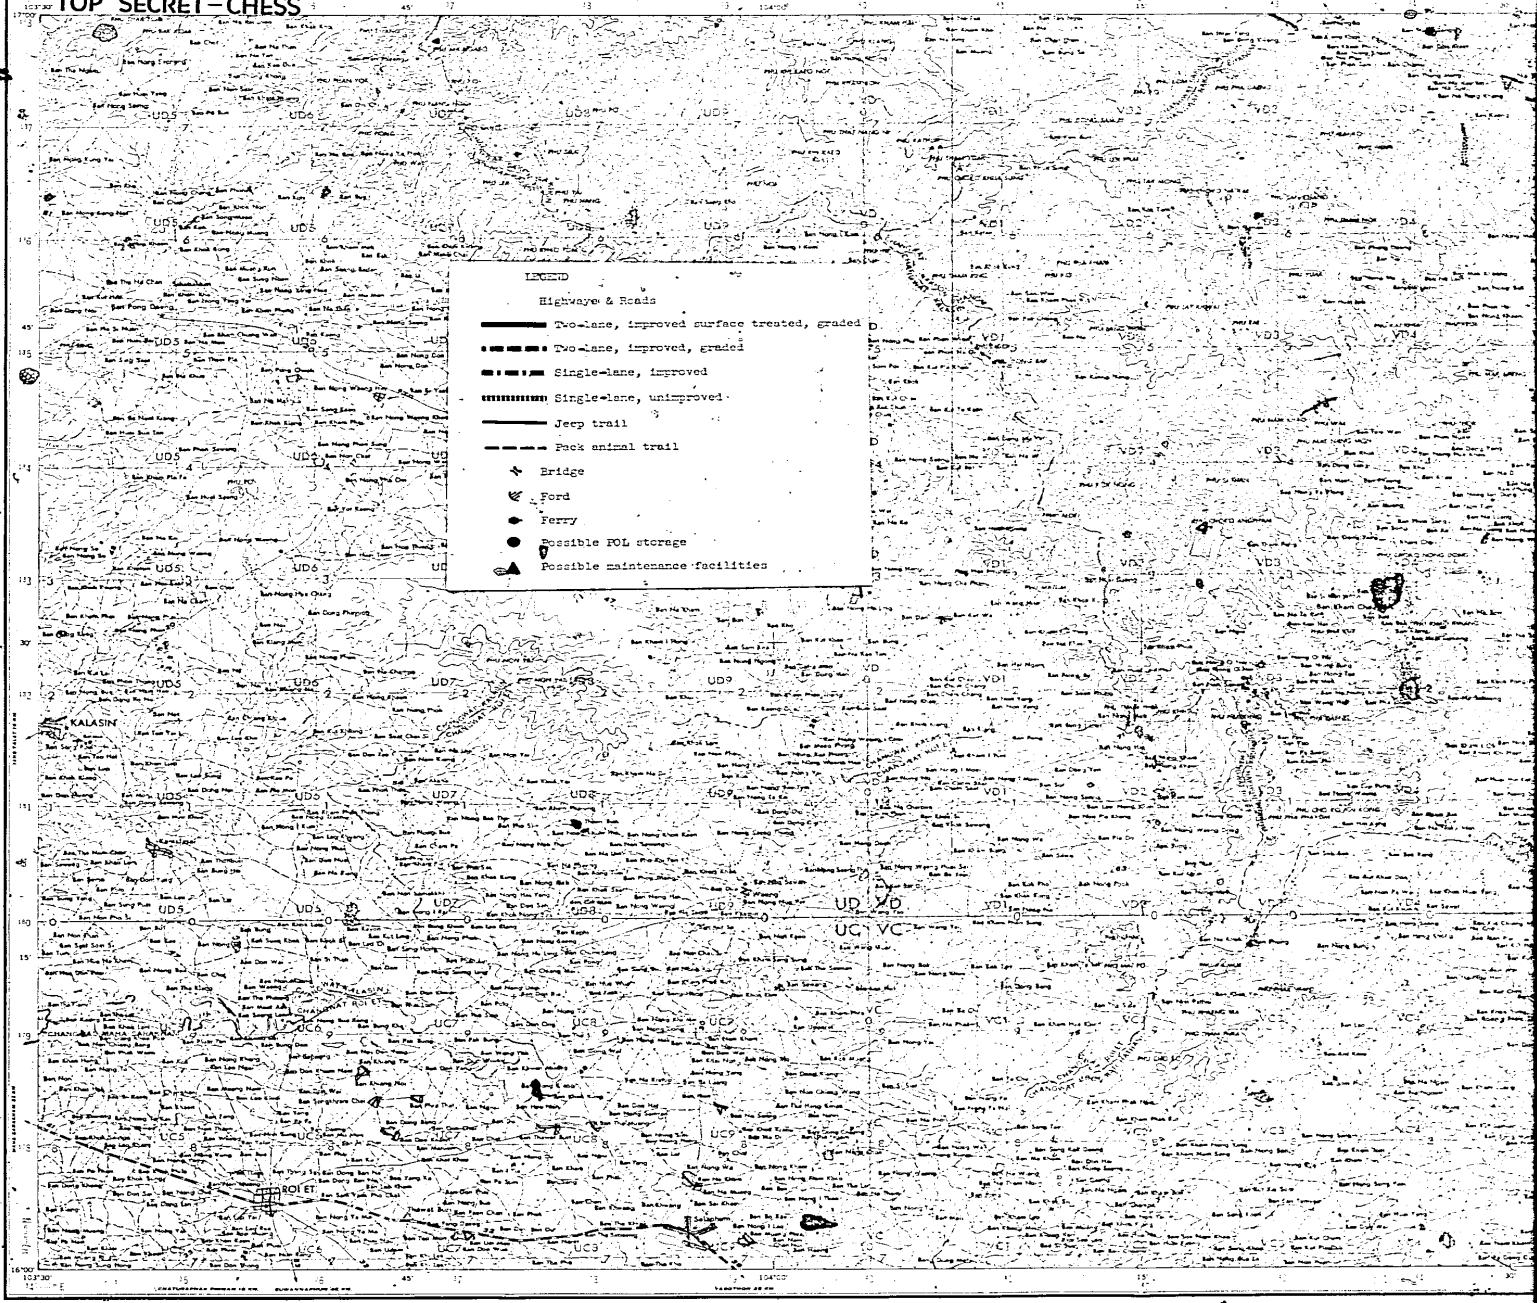

CIA/PTR/IB-4P-441/64

KRUNG THEP

NAKHON RATCHASIMA

MAHA SARAKHAM

Location Diagram for NE 48-14

LOCATION DIAGRAM FOR NE 48-14

Scale 1:250,000

CONTOURS SPECIAL 15 METERS
WITH SUPPLEMENTARY CONTOURS AT 25 METER INTERVALS


TRANSVERSE MERCATOR PROJECTION

ROI ET

EDITION 2-AMS

REFER TO THIS MAP AS
NE 48-14
SERIES L-69

SECRET NO. 48-14
EDITION 2-AMS

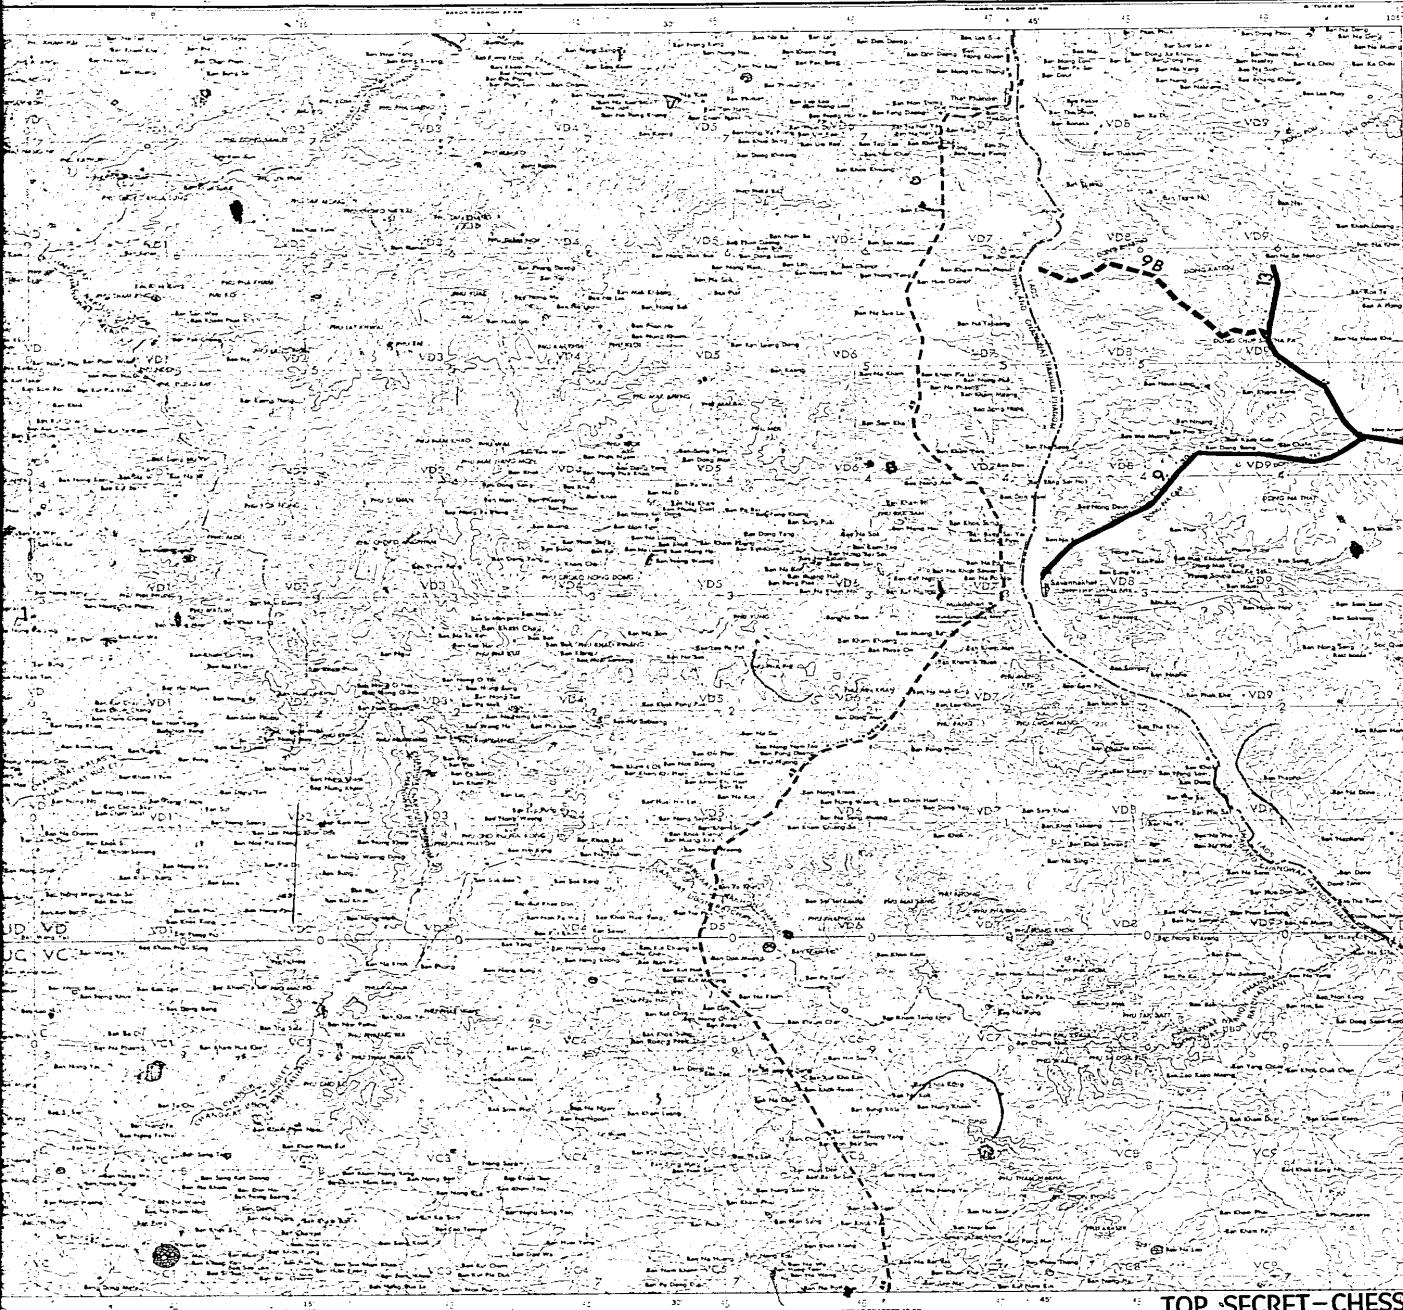

TOP SECRET - CHESS

SCALE 1:250,000

SEPARATE CLOTH

GLOSSARY GLOSSAIRE

PRINTED BY ARMY MAP SERVICE, CORPS OF ENGINEERS, 2-60 CON

CONTOUR INTERVAL 50 METERS
WITH SUPPLEMENTARY CONTOURS AT 15 METER INTERVALS
TRANSVERSE MERCATOR PROJECTION

THIS MAP IS NOT DRAWN TO SCALE. THE CENTER OF THE WEST BORDER IS APPROXIMATELY 10 KM. WEST OF THE CENTER OF THE EAST BORDER. THE CENTER OF THE SOUTH BORDER IS APPROXIMATELY 10 KM. SOUTH OF THE CENTER OF THE NORTH BORDER. THE CENTER OF THE NORTH BORDER IS APPROXIMATELY 10 KM. NORTH OF THE CENTER OF THE SOUTH BORDER.


ROI ET, THAILAND, LAOS

HUE

EDITION 2-AMS

REFER TO THIS MAP AS
NE 48.16
SERIES 1529

SECRET - CHESS
SERIAL NO. 15
EDITION 2-AMS

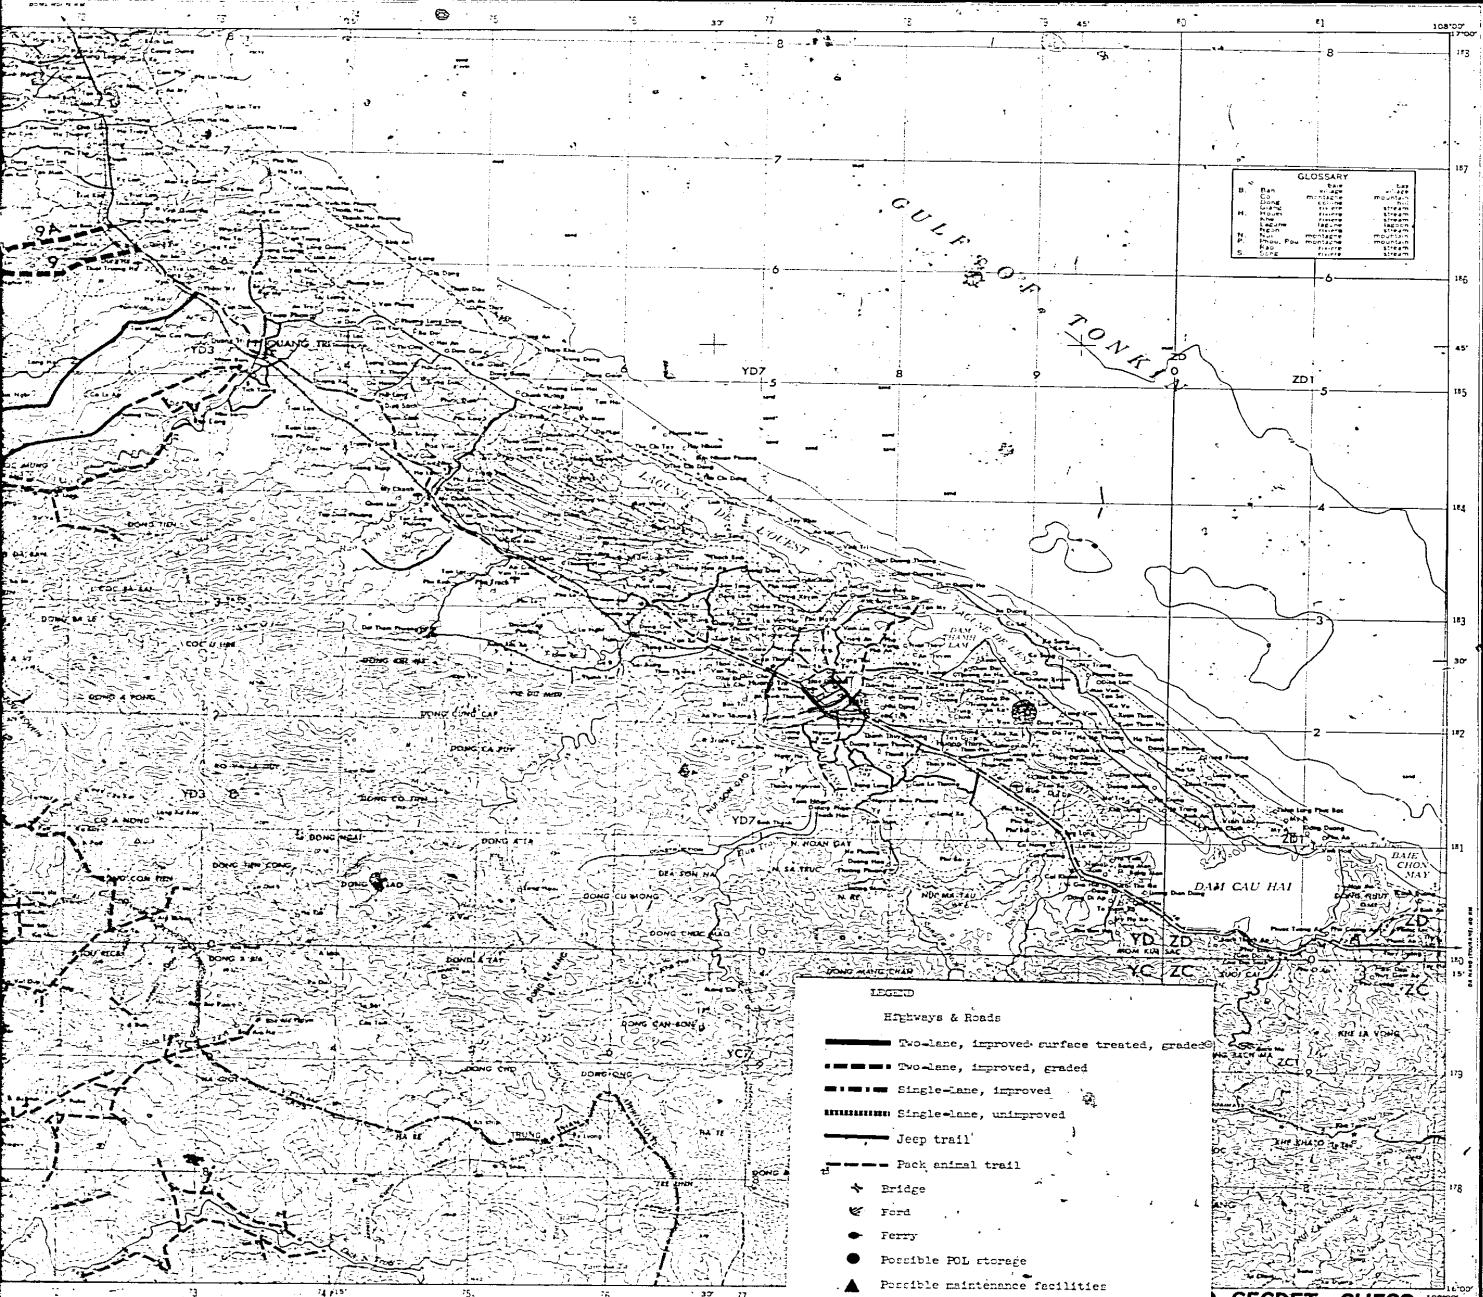


SECRET - CHESS

Scale 1:250,000

CONTOUR INTERVAL 100 METERS
TRANSVERSE MERCATOR PROJECTION

This map is a copy of a classified document. It contains sensitive information and is subject to strict handling and disposal regulations. It is not to be distributed outside the authorized personnel who have a valid need to know.

LOCATION DIAGRAM FOR NE 48.16	
NE 48.16	NE 48.16

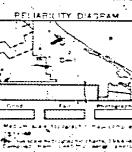


B-42 PRINTED BY ARMY MAP SERVICE, CORPS OF ENGINEERS			
NE 48.16	NE 48.16	NE 48.16	NE 48.16
NE 48.16	NE 48.16	NE 48.16	NE 48.16
NE 48.16	NE 48.16	NE 48.16	NE 48.16
NE 48.16	NE 48.16	NE 48.16	NE 48.16

HUE, VIETNAM; LAOS

INDOCHINA AND THAILAND 1:250,000
(LAOS/THAILAND/VIETNAM)

TCHEPONE

TOP SECRET-CHESS

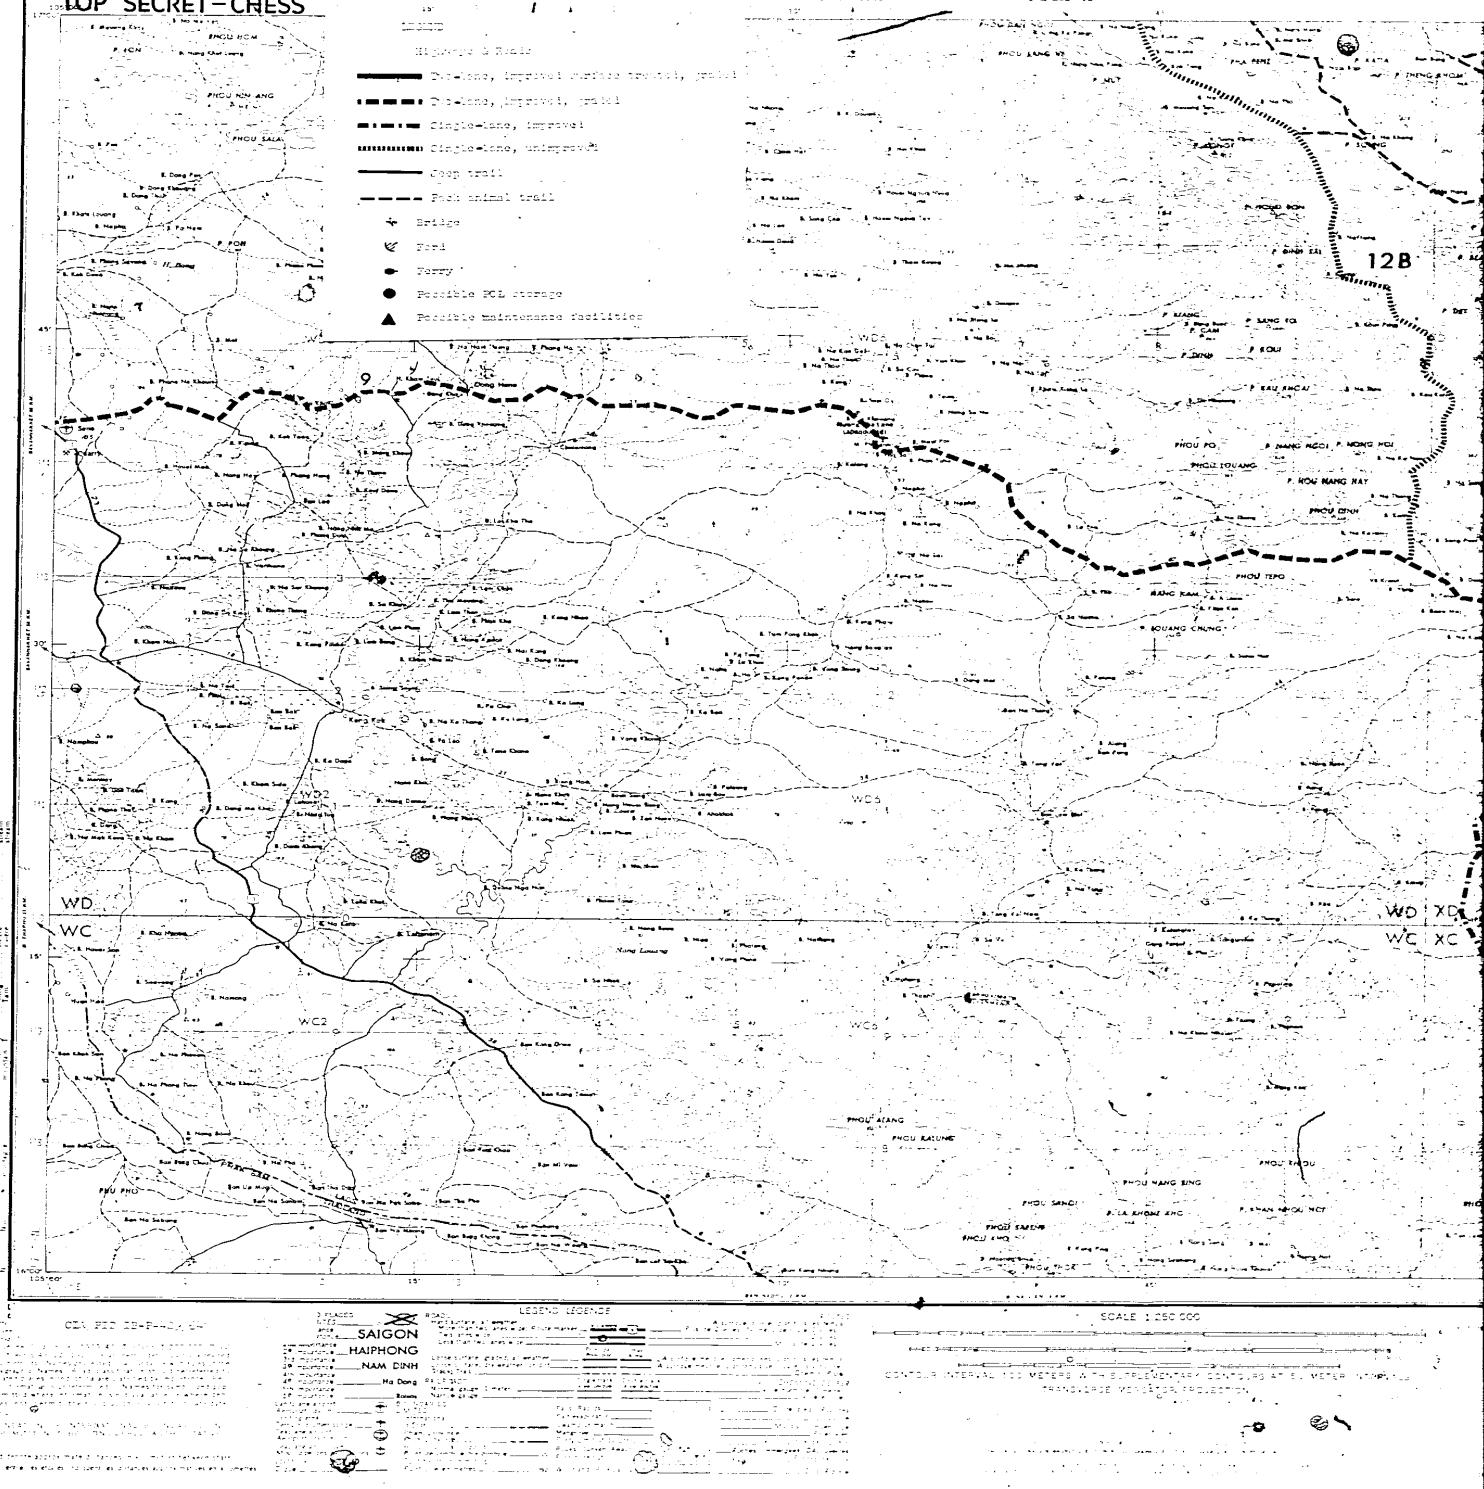

TCHEPONE

EDITION 2-AMS

REFER TO THIS MAP AS
LINE 48:15
SERIES 605

SERIES 605
SHEET NO 405
EDITION 2-AMS

12B

Maintenance ends - here to border

Detailed study not possible due to obliquity

TOP SECRET-CHESS

SCALE 1:250,000

CONTOUR INTERVAL 100 METERS WITH SUPPLEMENTARY CONTOURS AT 50 METER INTERVALS
TRANSVERSE MERCATOR PROJECTION

642 PLANE EX-ARMY MAP SERVICE CORPS OF ENGINEERS

TCHEPONE, LAOS; THAILAND; VIETNAM